

## SIDE SEWER CONSTRUCTION DRAWING

ADDRESS \_\_\_\_\_

PERMIT NO. \_\_\_\_\_

CONTRACTOR \_\_\_\_\_

LIC. NO. \_\_\_\_\_

DRAWN BY \_\_\_\_\_

ITEMS REQUIRED TO BE SHOWN ON THE SIDE SEWER DRAWING.

DATE APPROVED \_\_\_\_\_

BY \_\_\_\_\_

NORTH ARROW; STREET NAMES; BLDG. OUTLINE (ENOUGH TO SHOW CONNECTION); RIGHT OF WAY LINE; PIPE TYPES, DIAMETERS, AND LENGTHS; FITTINGS; CONNECTION TO THE SEWER MAIN; UPSTREAM AND DOWNSTREAM MANHOLES; AND DIMENSIONS ADEQUATE TO LOCATE PIPE AND FITTINGS.

DISTANCE FROM MH NO. \_\_\_\_\_ TO TEE IS \_\_\_\_\_ FT.

DEPTH OF SIDE SEWER AT PROPERTY LINE \_\_\_\_\_ FT.

DEPTH OF PIPE AT HOUSE CONNECTION \_\_\_\_\_ FT.

COMMERCIAL OR DOMESTIC JOINT USE: YES NO

BASEMENT CONNECTED? YES NO DO NOT KNOW

HOW TESTED? AIR WATER

CONNECTION AT MAIN: CUT IN TEE HOLE CUT EXISTING STUB



# SIDE SEWER CONSTRUCTION DRAWING

ADDRESS 2640 26TH PL SE

CONTRACTOR Smith Excavating

PERMIT NO. GWR11-0019

LIC. NO. NA


DRAWN BY RILEY

DATE APPROVED 3/8/13

BY RILEY

ITEMS REQUIRED TO BE SHOWN ON THE SIDE SEWER DRAWING.

NORTH ARROW; STREET NAMES; BLDG. OUTLINE (ENOUGH TO SHOW CONNECTION); RIGHT OF WAY LINE; PIPE TYPES, DIAMETERS, AND LENGTHS; FITTINGS; CONNECTION TO THE SEWER MAIN; UPSTREAM AND DOWNSTREAM MANHOLES; AND DIMENSIONS ADEQUATE TO LOCATE PIPE AND FITTINGS.

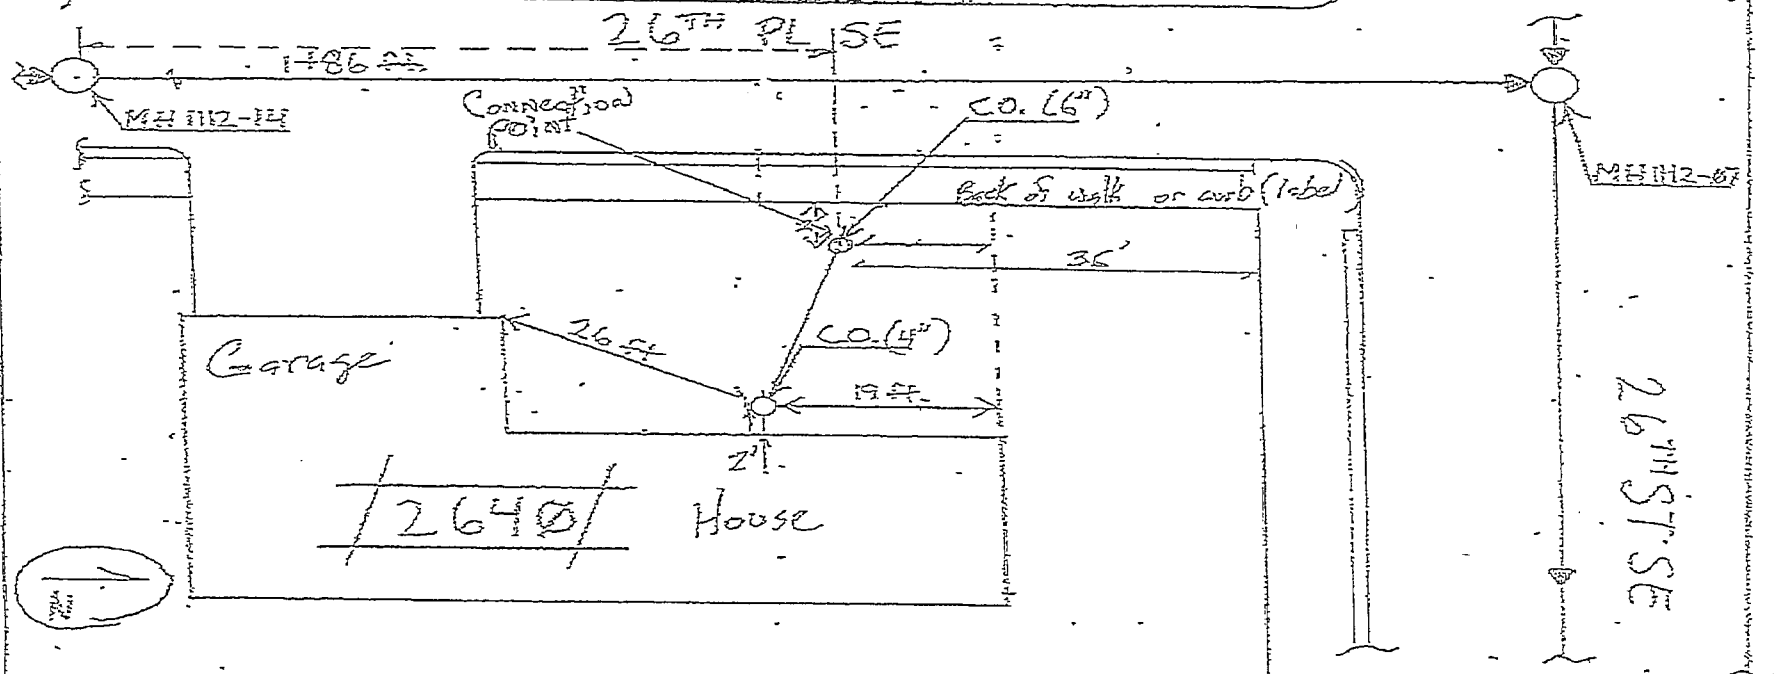

DISTANCE FROM MH NO. 112-07 TO TEE IS 40 FT.  
DEPTH OF SIDE SEWER AT PROPERTY LINE 2' FT.  
DEPTH OF PIPE AT HOUSE CONNECTION 3' FT.

COMMERCIAL OR DOMESTIC JOINT USE YES NO  
BASEMENT CONNECTED? YES NO DO NOT KNOW  
HOW TESTED? AIR WATER

CONNECTION AT MAIN: CUT IN TEE HOLE CUT EXISTING STUB

# EXAMPLE